


OFFICE OF THE MARION COUNTY SURVEYOR
SECTION RECORD CORNER
SECTION 22 TOWNSHIP 17 RANGE 5
DATE: --7-14-99-- 8-6-04
PARTY CHIEF: ---Kiste Wilcoxon
CREW: _____
TYPE OF MARKER: Harrison
METHOD OF ESTABLISHMENT: County: 2-17-83
EDM ties

IN. S.P.C. E ZONE, NAD 83
NAME: 17052203
N: 517900.1692(m)
E: 76791.9839(m)

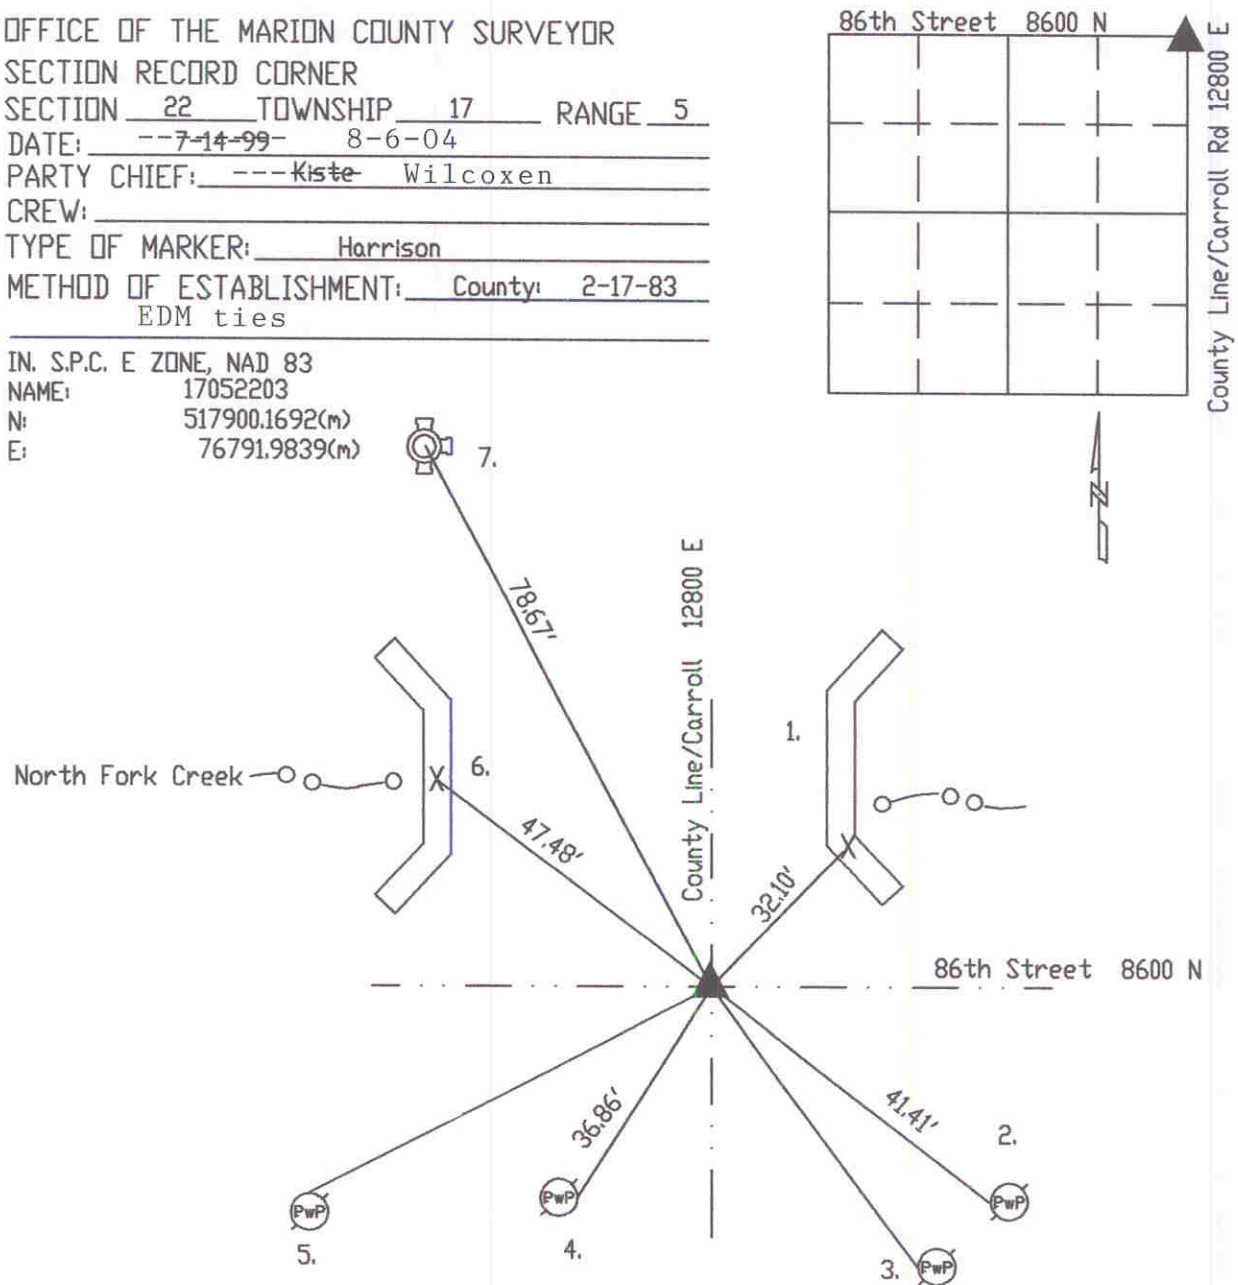

Survey in 1821 by Wm. B. Laughlin with witnesses: 10" black walnut N 18 links, and 12" buckeye S 15 E 21 links. No legal surveys identify the corner per Township Books. August, 1962 by Butler submitted to MCS by Charle Campbell 8-9-74 called corner galvanised bolt. Cripe 5-23-74 (JOB#7426) called bolt. 5-21-75 Fortner called steel bolt and reflected the Cripe tie dimensions. Hancock 5-16-77 called a stone 8" down. A brass plug and plate set over stone. Hancock was within 0.1' +/- . Re-tied 7-14-99 by Kiste.

HC752203

REF.	DISTANCE	DESCRIPTION
1.	32.10'	Cut 'x' S-end of concrete headwall over North Fork creek
2.	41.41'	Mag nail w/MCS brass washer W PwP no# 12'up #245-221HB
3.	44.29'	Mag nail w/MCS brass washer W PwP no# 12'up
4.	36.86'	PK nail E PwP no# 18'up #10-221HB
5.	61.46'	Mag nail w/MCS brass washer N PwP no# 24'up #9-221HB
6.	47.48'	Cut 'x' in center of concrete headwall over creek
7.	78.67'	Top nut of fire hydrant